 
 
 







 

 





KEY:

-  = COMMISSIONING VALVE
-  = ISOLATION VALVE
-  = PRESSURE GAUGE
-  = TEMPERATURE GAUGE
-  = FLEXIBLE CONNECTION
-  = LOCKSHIELD VALVE
-  = AIR VENT
-  = DRAIN COCK
-  = DOUBLE REGULATION VALVE
-  = AUTOMATIC AIR VENT
-  = PNEUMATICALLY OPERATED VALVE
-  = FLEXIBLE HOSE
-  = EXISTING PIPEWORK
-  = NEW PIPEWORK
-  = SAFETY VALVE



**RECORD DRAWING**

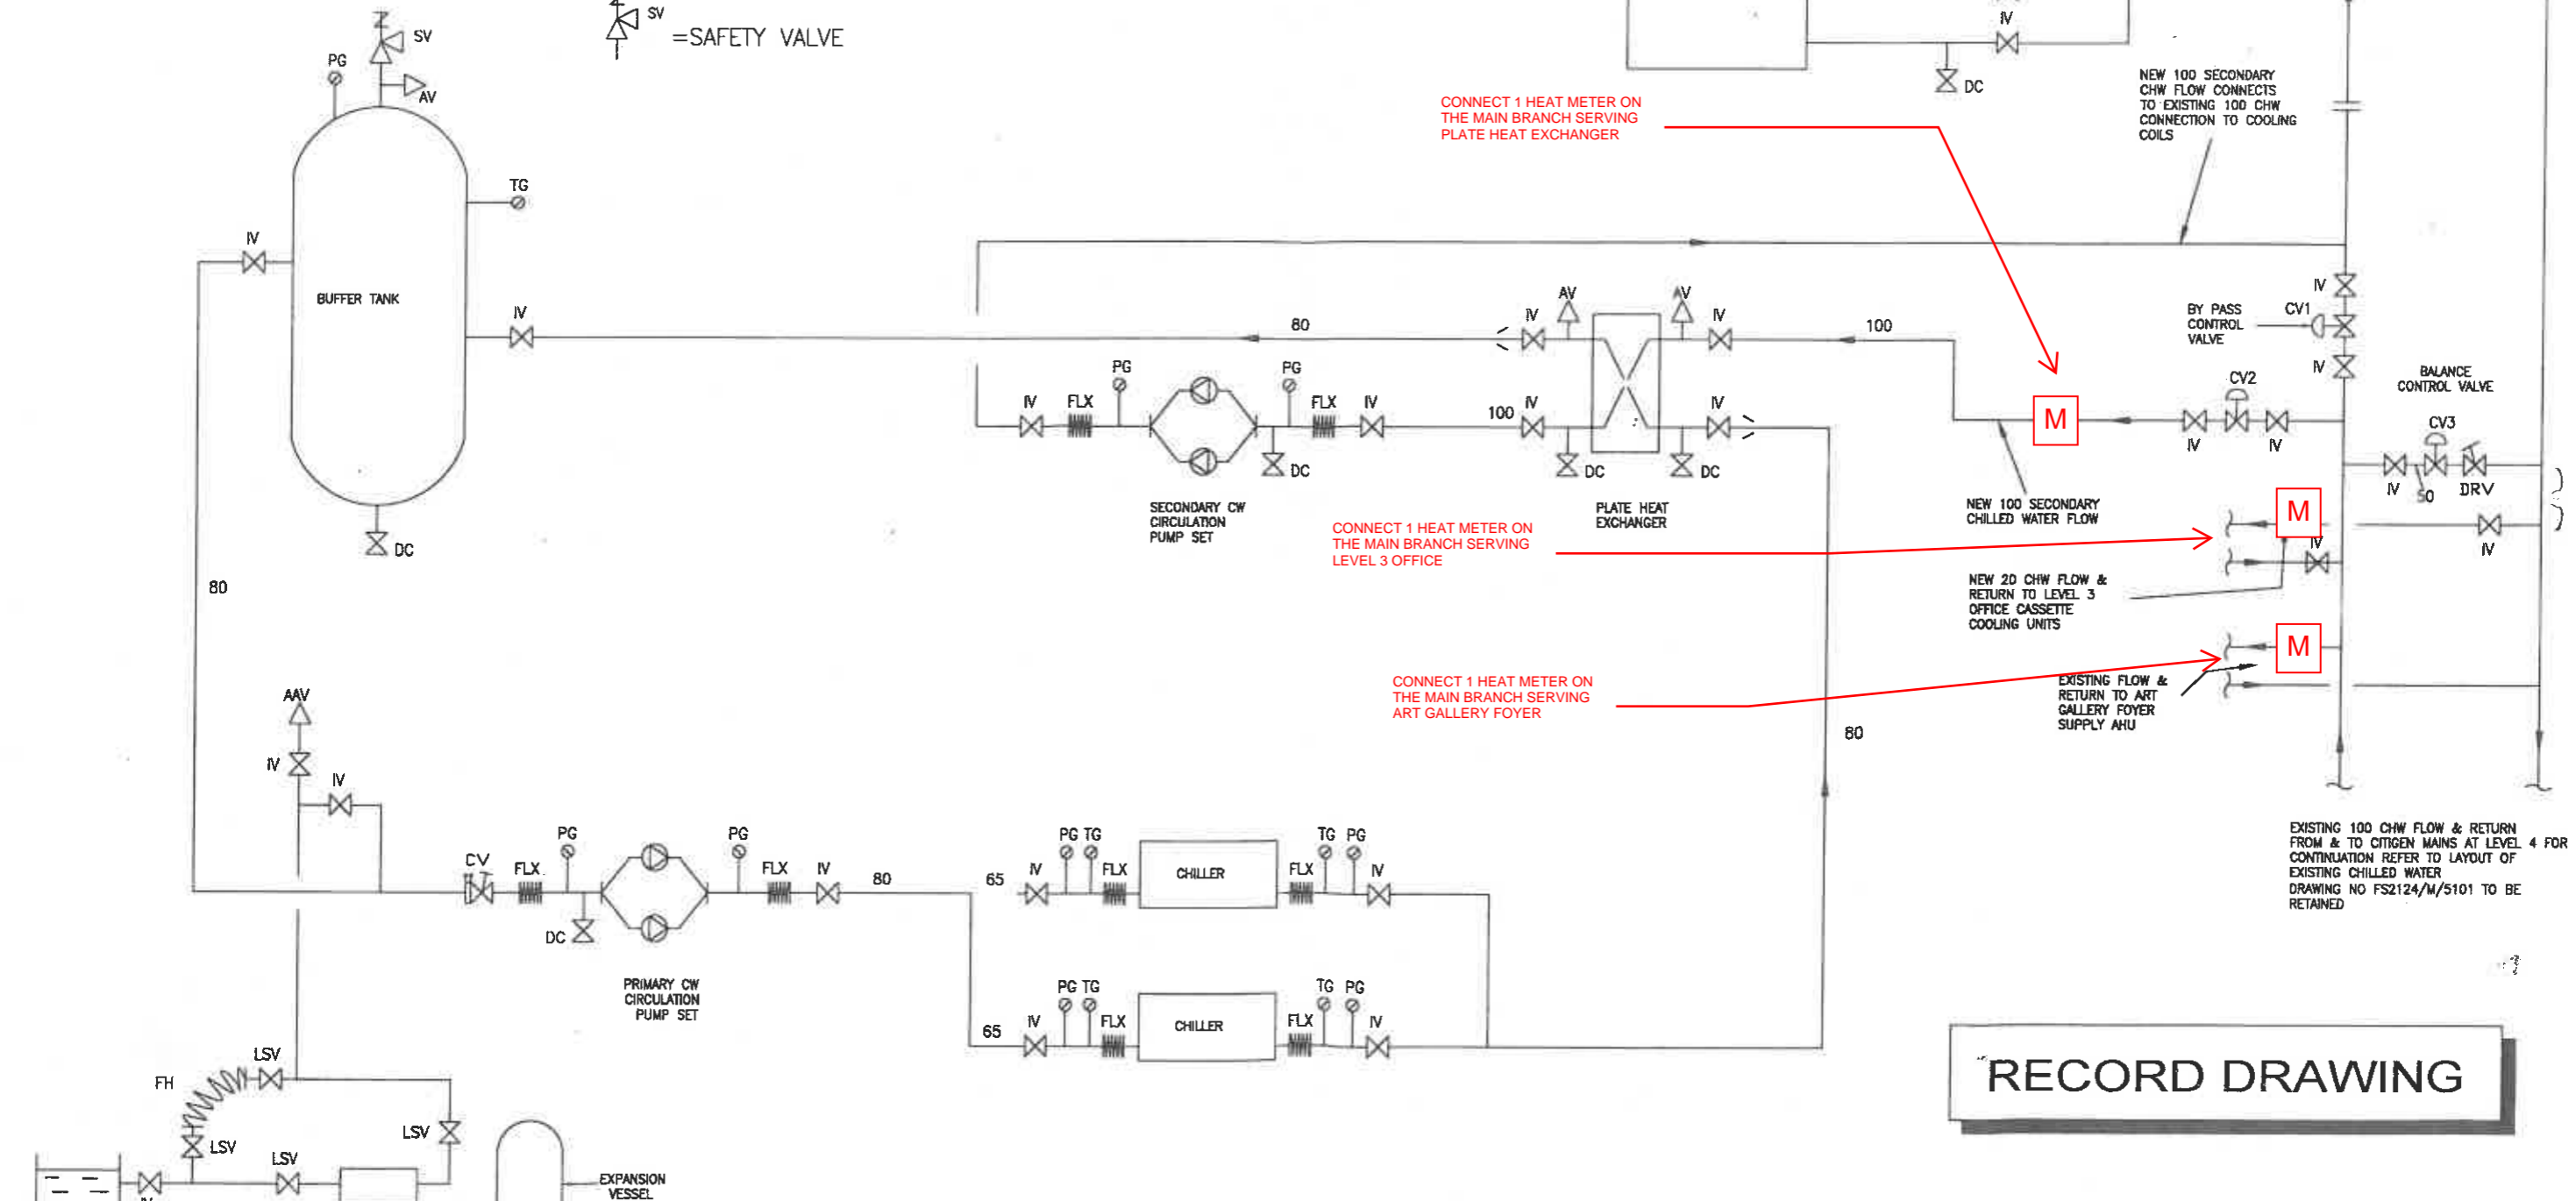

Sir Frederick Snow & Partners Ltd.  
CONSULTING ENGINEERS  
17 LANSDOWNE ROAD  
DROYSDEN, CR0 2BX, UK  
Tel: 020 8805 8998  
Fax: 020 8804 8877  
Email: post@snow.co.uk












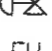






**ALLIED**  
www.alliedservices.co.uk  
Tel: 01638 661062 Fax: 01638 666538  
Depot Rd Newmarket Suffolk CB8 0AP info@alliedservices.co.uk

PROJECT **BARBICAN CENTRE  
ART GALLERY SUPPLEMENTARY  
DE-HUMIDIFICATION**  
TITLE **SCHEMATIC LAYOUT OF PROPOSED  
CHILLED WATER DISTRIBUTION  
TO ART**

DRAWN CD	APPROVED
SCALE NTS	DATE 18.09.08
DRAWING No 7897/M/5402	REV

KEY:

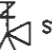-  = COMMISSIONING VALVE
-  = ISOLATION VALVE
-  = PRESSURE GAUGE
-  = TEMPERATURE GAUGE
-  = FLEXIBLE CONNECTION
-  = LOCKSHIELD VALVE
-  = AIR VENT
-  = DRAIN COCK
-  = DOUBLE REGULATION VALVE
-  = AUTOMATIC AIR VENT
-  = PNEUMATICALLY OPERATED VALVE
-  = FLEXIBLE HOSE
-  = EXISTING PIPEWORK
-  = NEW PIPEWORK
-  = SAFETY VALVE

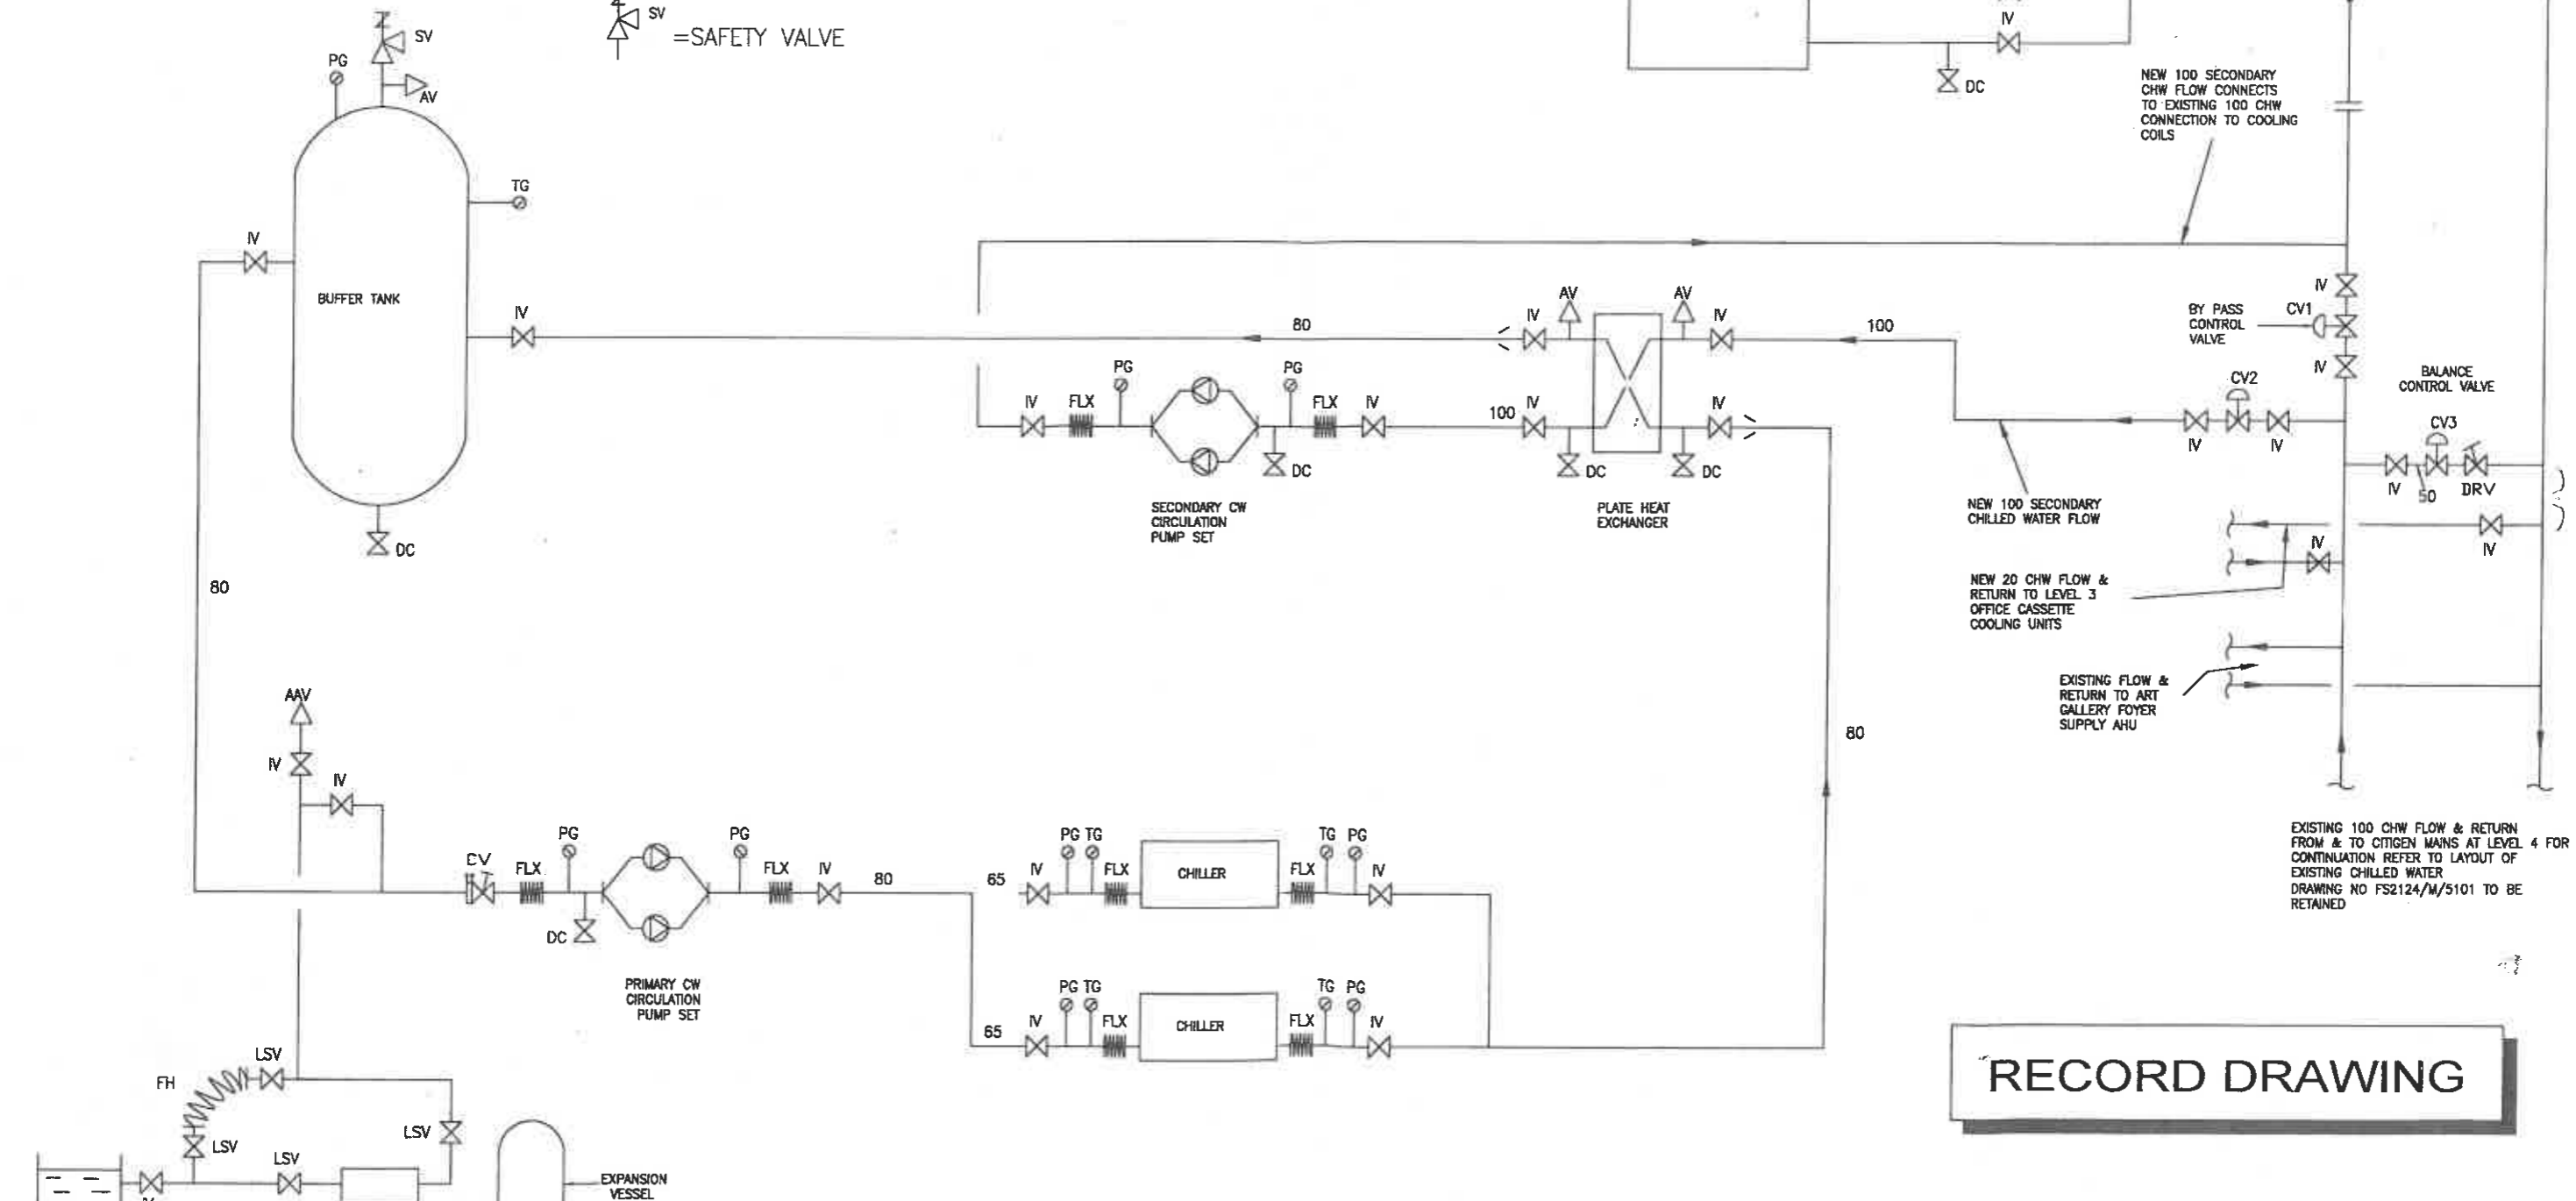

RECORD DRAWING

EXISTING 100 CHW FLOW & RETURN FROM & TO CITIGEN MAINS AT LEVEL 4 FOR CONTINUATION REFER TO LAYOUT OF EXISTING CHILLED WATER DRAWING NO FS2124/M/5101 TO BE RETAINED

3% ETHYLENE GLYCOL / 80% WATER SOLUTION  
TANK

Sir Frederick Snow & Partners Ltd.  
CONSULTING ENGINEERS  
17 LANSDOWNE ROAD  
CRYSTAL CRUISE, UK  
Tel: 020 8605 8899  
Fax: 020 8604 5277  
Email: psf@sfpsnow.co.uk



**ALLIED**  
www.alliedservices.co.uk  
Tel: 01638 661062 Fax: 01638 666538  
Depot Rd Newmarket Suffolk CB8 0AP info@alliedservices.co.uk

PROJECT **BARBICAN CENTRE  
ART GALLERY SUPPLEMENTARY  
DE-HUMIDIFICATION**  
TITLE **SCHEMATIC LAYOUT OF PROPOSED  
CHILLED WATER DISTRIBUTION  
TO ART**

DRAWN <b>CD</b>	APPROVED
SCALE <b>NTS</b>	DATE <b>18.09.08</b>
DRAWING No <b>7897/M/5402</b>	REV